



Dart Aerospace Ltd.
1270 Aberdeen St
Hawkesbury, ON
K6A 1K7
Canada

Tel (613) 632-5200

RBT18205
Job Sheet 168015



NCL-19-7385

Part No: RBT18205

Job Qty: 1 ea

Part Name: Hydraulic Filter Bowl Wrench



Part Weight: 0 lbs

Status: Scheduled

Priority: Medium

Job Created: 11/9/17

Job Tracking No:

Due Date: 11/20/17

Created By: Marie Lajeunesse

Type: Stock

Description:

Customer: Hell Centre Australia Pty Ltd (CHCEN07)

PO Box 4018 Mackay, Queensland, 4740 Australia ph:+61 7 4944 0455

Note: DWG RBT18205 Rev C. IPP Rev.A 17.09.05 New issue DP Verify DD/IPP Rev B 17.12.04 DWG Rev. C DP Verify DD

Ship Via:

Bill of Materials

Job Routing

Op No	Operation	Qty	Start Date	Due Date	Standard		Workcenter/Supplier		Sign-off
					Setup hrs	Run Hrs	Workcenter / Supplier	Lead Time	
90	Start up Operation	1 Ea		11/18/17	0.00	0.00	Start Up Small Fab		ML
100	Small Fab	1 pcs		11/20/17	0.00	1.00	Small Fab		ML DAE
120	QC	1 pcs		11/20/17	0.00	0.00	QC5		38
130	Packaging	1 pcs		11/20/17	0.00	0.00	Packaging3	GA	A7
140	QC21-FG	1 Ea		11/20/17	0.00	0.00	QC21		JAN 11 2016

Part Op 100 - 1-Engrave placard RB41011 using marktronic engraver as per Dart QSI 044 2-Transfer drill Dart placard RB41011
Descriptions: into Pelican case APP-1040-E 3-Deburr holes and remove chips from case. 4-Rivet Dart placard to Pelican case 5-Glue foam and pack case as per DWG.

Job Allocations

Operation	Component Part	Required	Inventory	Allocated	Std Qty
90-Start up Operation	97524A032	4	116	0	0
	APP-1040-E	1	1	0	0
	RB41011	1	968	0	0
	RBT18205-1	1	1	0	0
	RBT18205-3	1	1	0	0
	RBT18205-4	1	1	0	0

*USE -4 THIS TIME ONLY
VIT 12/18/2017*

Part Specifications




Specifications could not be found.

Plex 12/18/17 1:16 PM Dart.lajeunesse.marie

P.T.O.

ITEM #	QTY	PART #	TITLE	PG
-1	1	RBT18205-1	WRENCH	2
-9	1	RBT18205-9	PACKAGING ASSY	3
11	1	RB41011	DART PLACARD	-
13	4	McMaster#97524A032	RIVET 1/8" x 0.425" LG.	-

REV.	DESCRIPTION	ECN #	DATE	BY	APPROVED
1	RELEASE FOR PRODUCTION	-	11/9/2016	RJC	JAG
B	DART PLACARD ADDED, TEMPLATE UPDATED, PACKAGING ASSY ADDED -9	17-630	17.08.05	VM	WM
C	RENUMBERING ITEM # TO PREVIOUS REV 1, NOTE 8 & 8 ADDED, ITEM 13 RIVETS ADDED, NOTE 6 ON -1 CHANGED, NOTES ON -9 ADDED	17-661	17.11.28	VM	WM

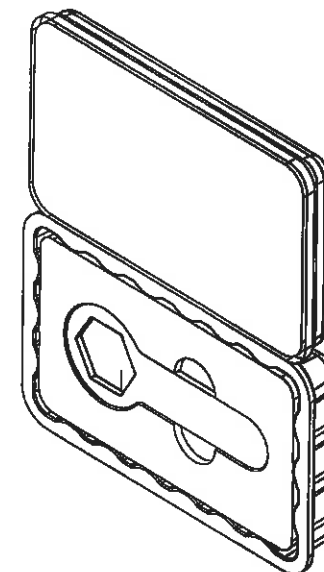
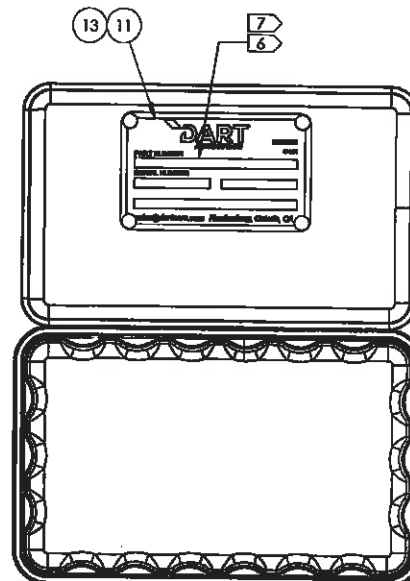
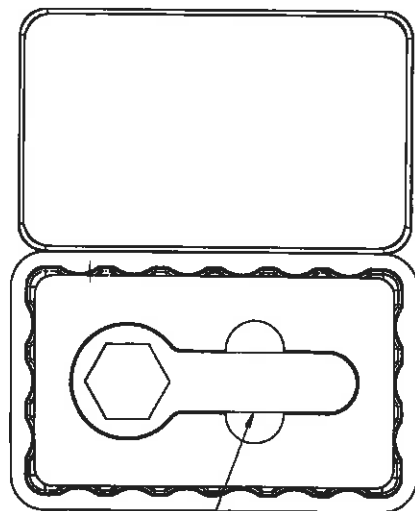


NOTES:

- 1) MATERIAL: N/A
- 2) FINISH: N/A
- 3) HEAT TREAT: N/A
- 4) SPEC: N/A
- 5) BREAK ALL SHARP EDGES : N/A
- 6) IDENTIFICATION: ENGRAVE PN & SN WHERE INDICATED PRIOR INSTALLATING THE DART PLACARD ONTO THE TOP LID OF THE PELICAN CASE
- 7) INSTALL RB41011 PLACARD IN THE AVAILABLE AREA ON THE LID OF THE PELICAN CASE PRIOR TO GLUING THE RBT18205-3 BOTTOM FOAM AND THE RBT18205-5 TOP FOAM TO THE PELICAN CASE
- 8) HOT GLUE -3 BOTTOM FOAM AND -5 TOP FOAM INTO THE PELICAN CASE
- 9) REFERENCE ERA T/N ST13059-ERA

RBT18205 HYDRAULIC FILTER BOWL WRENCH

DART AEROSPACE		Hamilton, Ontario, Canada	
TITLE HYDRAULIC FILTER BOWL WRENCH			
DWG NO. RBT18205		REV C	
DESIGN BY: VM 9/5/2017	DATE: 11/28/2017	SCALE: NTS	WEIGHT: SHEET 1 OF 5
DRAWN BY: VM 11/28/2017	CHECKED BY: WM 11/30/2017	APPROVED BY: PD 9/15/2017	DATE: 11/28/2017
1. DIMENSIONS ARE IN INCHES		2. DIMENSIONS ARE IN MILLIMETERS	
3. DIMENSIONS ARE IN MILLIMETERS		4. DIMENSIONS ARE IN MILLIMETERS	
5. DIMENSIONS ARE IN MILLIMETERS		6. DIMENSIONS ARE IN MILLIMETERS	
7. DIMENSIONS ARE IN MILLIMETERS		8. DIMENSIONS ARE IN MILLIMETERS	
99. DIMENSIONS ARE IN MILLIMETERS		100. DIMENSIONS ARE IN MILLIMETERS	

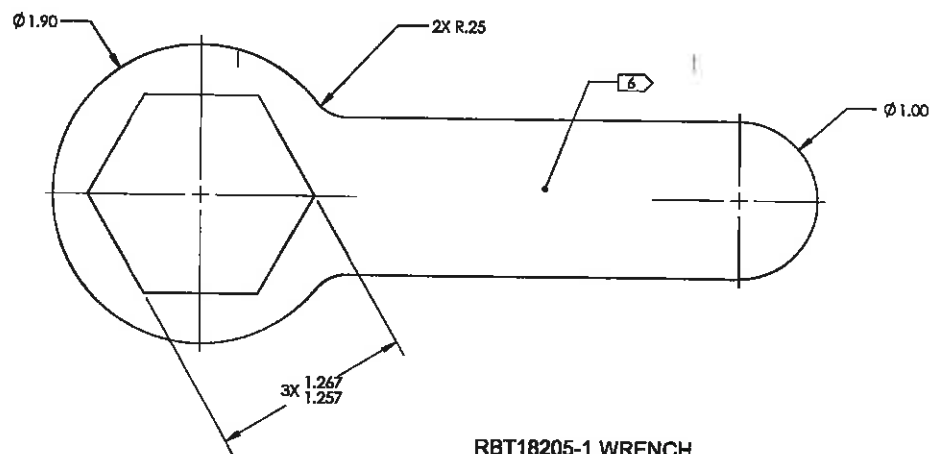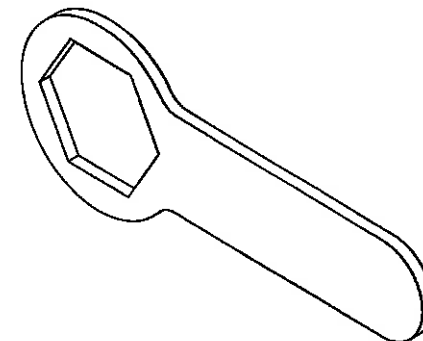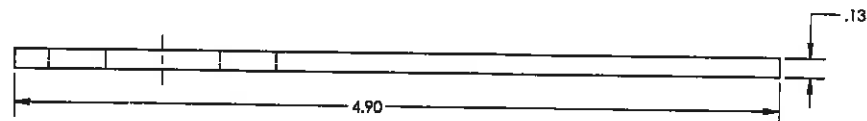


RBT18205-1 WRENCH

- NOTES:**
- 1) MATERIAL: 6061-T6
 - 2) HEAT TREAT: N/A
 - 3) FINISH: CLEAR ANODIZE
 - 4) SPEC: MIL-A-8625, TYPE II, CLASS 1; WATER SEALANT
 - 5) BREAK ALL SHARP EDGES .015 x 45° OR .015R
 - 6) IDENTIFICATION: ENGRAVE T/N "RBT18205" & S/N

DART AEROSPACE Newbury, Ontario, Canada	
WRENCH	
DATE: 11/28/2017	REV: C
DESIGN BY: VM 9/5/2017	JOCK: 2.000 FRACTIONS: 2 1/8
DRAWN BY: VM 11/28/2017	JOCK: 2.000 ANGLES: 45°
CHECKED: WM 11/30/2017	JOCK: 2.000 SURFACES: 42°
MFG. APPR: DD 12/01/2017	1. DIMENSIONS ARE IN INCHES
QA APPR: PD 09/15/2017	2. INTERPRET DIM AND TOL PER ASME Y14.5M-2009
DATE: 11/28/2017	3. DIMENSIONAL LIMITS APPLY
SCALE: NTS	WEIGHT: SHEET 2 OF 5
COPYRIGHT © 2017 BY DART AEROSPACE LTD THIS DOCUMENT IS UNCLASSIFIED AND IS RELEASED ON THE BASIS THAT IT IS NOT TO BE UNCLASSIFIED FOR PURPOSES OF COMING OR CONSIDERED TO ANY OTHER PERSONS WITHOUT PERMISSION FROM DART AEROSPACE LTD.	

ITEM #	QTY	PART #	TITLE	PG
-3	1	RBT18205-3	BOTTOM FOAM	4
-5	1	RBT18205-5	TOP FOAM	5
7	1	PELICAN #APP-1040-E	PELICAN CASE	-

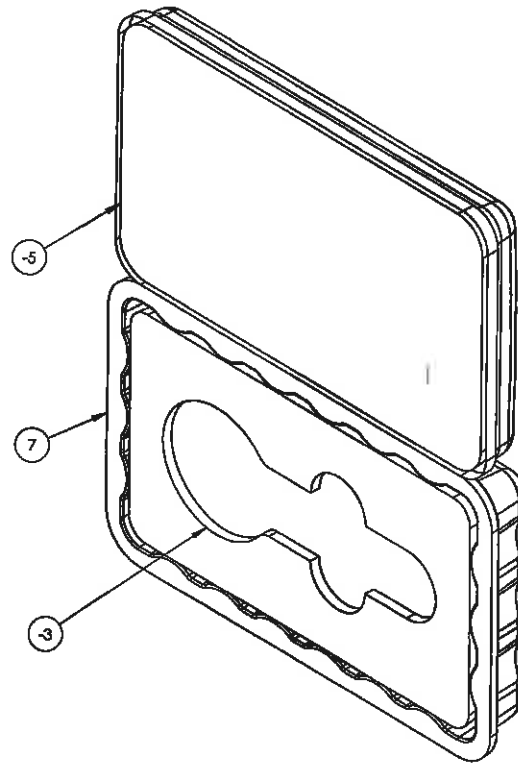

RBT18205-9 PACKAGING ASSY

NOTES:

- 1) MATERIAL: N/A
- 2) HEAT TREAT: N/A
- 3) FINISH: N/A
- 4) SPEC: N/A
- 5) BREAK ALL SHARP EDGES: N/A
- 6) IDENTIFICATION: N/A

DART AEROSPACE Mississauga, Ontario, Canada			
PACKAGING ASSY			
DWG NO.		REV	
RBT18205-9		C	
DESIGN BY:	WM 8/5/2017	JOCK 2.288	FRACTIONS 2/16
DRAWN BY:	WM 11/28/2017	JK 2.41	ANGLES 2.1°
CHECKED:	WM 11/30/2017	2	SURFACES 128
MFG. APPR:	DD 12/01/2017	1. DIMENSIONS ARE IN INCHES	
QA APPR:	PD 8/15/2017	2. INTERPRET DIM AND TOL PER ASMR Y14.33-2009	
APPROVED:	WM 12/01/2017	3. DIMENSIONAL LIMITS APPLY AFTER PLATING	
DATE: 11/28/2017	SCALE: NTS	WEIGHT: N/A	SHEET 3 OF 5
COPYRIGHT © 2017 BY DART AEROSPACE LTD. THIS DOCUMENT IS UNCLASSIFIED AND IS SUPPLIED ON THE UNDERSTANDING THAT IT IS NOT TO BE USED FOR ANY PURPOSE OR COPIED OR COMMUNICATED TO ANY OTHER PERSON WITHOUT WRITTEN PERMISSION FROM DART AEROSPACE LTD.			



8 7 6 5 4 3 2 1

D


C

B

A

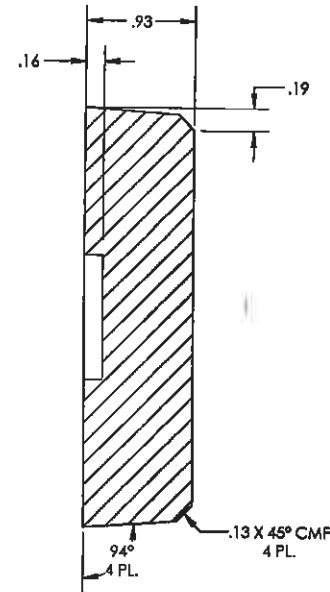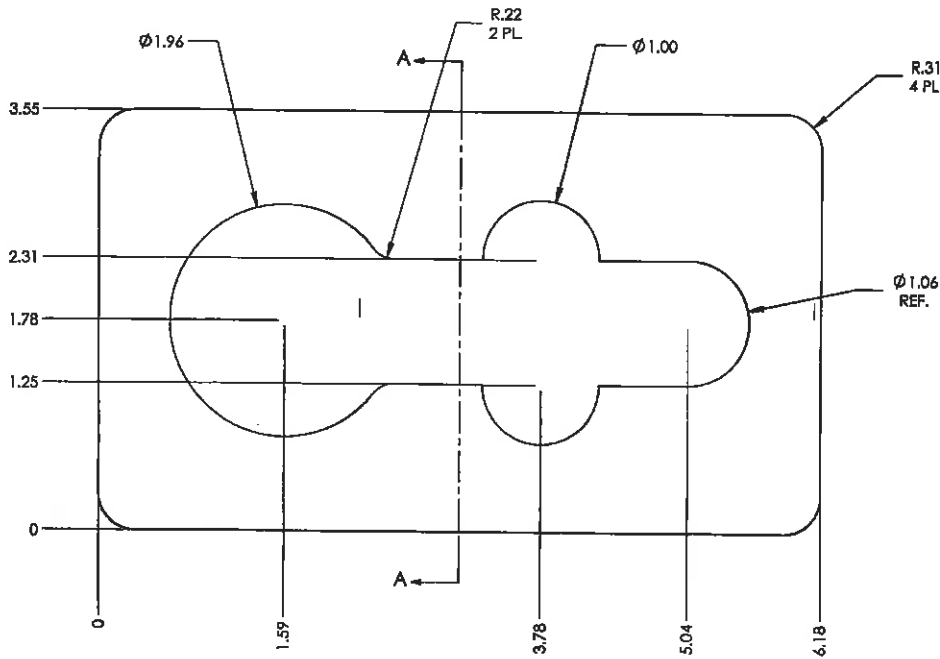

SECTION A-A

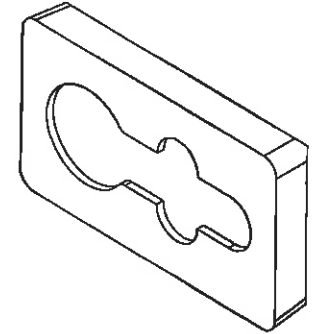

RBT18205-3 BOTTOM FOAM

- NOTES:**
 1) MATERIAL: ETHAFOAM 220, BLACK
 2) FINISH: N/A
 3) HEAT TREAT: N/A
 4) SPEC: N/A
 5) BREAK ALL SHARP EDGES: N/A
 6) IDENTIFICATION: N/A

DART AEROSPACE Hamilton, Ontario, Canada			
TITLE BOTTOM FOAM			
DWG NO. RBT18205-3		REV C	
DESIGN BY: VM 11/28/2017	CHK'D BY: VM 11/28/2017	30X 2 .305	FRACTIONS & 1/8
DRAWN BY: VM 11/28/2017	CHECKED: VM 11/30/2017	30X 2 .31	ANGLES & 5°
DATE: 11/28/2017	DATE: 11/28/2017	30X 2 .31	SURFACES & 1/16"
Q/A APPR: DD 12/01/2017	PD 09/15/2017	1. DIMENSIONS ARE IN INCHES UNLESS OTHERWISE SPECIFIED	
APPROVED: VM 12/01/2017	DATE: 11/28/2017	2. INTERPRET DIM AND TOL PER ASME Y14.5M-2009	
SCALE: NTS	WEIGHT:	3. DIMENSIONAL LIMITS APPLY AFTER PLATING	
SHEET 4 OF 5			
COPYRIGHT © 2017 BY DART AEROSPACE LTD THIS DOCUMENT IS PROPRIETARY AND CONFIDENTIAL AND IS SUPPLIED ON THE EXPRESS UNDERSTANDING THAT IT IS NOT TO BE REPRODUCED OR COPIED IN ANY FORM OR BY ANY MEANS WITHOUT WRITTEN PERMISSION FROM DART AEROSPACE LTD.			

8 7 6 5 4 3 2 1



Dart Hawkesbury
1270 Aberdeen St
Hawkesbury, ON
K6A 1K7
Canada

Tel (613) 632-5200

RBT18205
Job Sheet 168015



Part No: RBT18205

Job Qty: 1 ea

Part Name: Hydraulic Filter Bowl Wrench



Part Weight: 0 lbs

Status: Scheduled

Priority: Medium

Job Created: 11/9/17

Job Tracking No:

Due Date: 11/20/17

Created By: Marie Lajeunesse

Type: Stock

Description:

Customer: Heli Centre Australia Pty Ltd (CHCEN07)

PO Box 4018 Mackay, Queensland, 4740 Australia ph:+61 7 4944 0455

Ship Via:

Bill of Materials

Job Routing

Op No	Operation	Qty	Start Date	Due Date	Standard		Workcenter/Supplier		Sign-off
					Setup hrs	Run Hrs	Workcenter / Supplier	Lead Time	
90	Start up Operation	1 Ea		11/18/17	0.00	0.00	Start Up Small Fab		ML
100	Small Fab ★ PTD	1 pcs		11/20/17	0.00	1.00	Small Fab		ML
120	QC	1 pcs		11/20/17	0.00	0.00	QC5		
130	Packaging	1 pcs		11/20/17	0.00	0.00	Packaging3		
140	QC21-FG	1 Ea		11/20/17	0.00	0.00	QC21		

Part Op 100 - 1-Engrave placard RB41011 using marktronic engraver as per Dart QSI 044 2-Transfer drill Dart placard RB41011
Descriptions: into Pelican case APP-1040-E 3-Deburr holes and remove chips from case. 4-Rivet Dart placard to Pelican case 5-Glue foam and pack case as per DWG.

Job Allocations

Operation	Component Part	Required	Inventory	Allocated	Std Qty
90-Start up Operation	97524A032 CA FN 138381	4	200	0	0
	APP-1040-E S015910	1	0	0	0
	RB41011 placard Alu S015627	1	0	0	0
	RBT18205-1 S014896	1	0	0	0
	RBT18205-3	1	0	0	0
	RBT18205-5	1	0	0	0


Part Specifications

Specifications could not be found.

Plex 11/9/17 1:12 PM Dart.lajeunesse.marie

ITEM #	QTY	PART #	TEXT	PG
1	1	RTB18205-1	WRENCH	2
2	1	RTB18205-2	WRENCH	2
6	1	RTB18205-6	DART PLACARD	1
7	4	RM 97524A032	RIVETS	1

REV.	DESCRIPTION	DATE	BY	APPROVED
1	RELEASED FOR PRODUCTION	11/8/2018	RJC	JAG
B	SEE ECRN 17-630	17.09.05	VM	WM

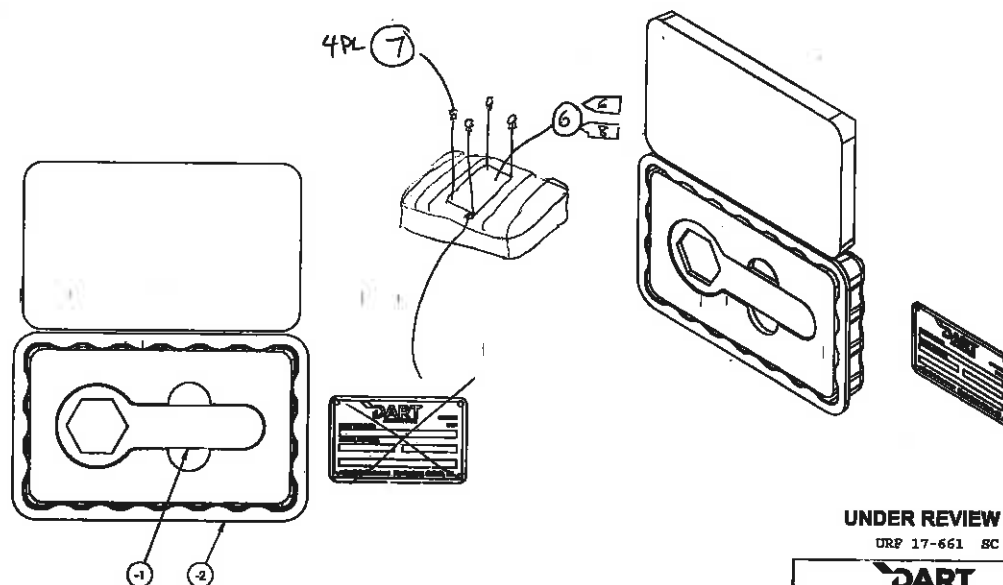

RBT18205 HYDRAULIC FILTER BOWL WRENCH

- NOTES:
- 1) MATERIAL: N/A
 - 2) FINISH: N/A
 - 3) HEAT TREAT: N/A
 - 4) SPEC: N/A
 - 5) BREAK ALL SHARP EDGES: N/A
 - 6) IDENTIFICATION: N/A ENGRAVE PART NUMBER "RBT18205" AND SERIAL NUMBER IN MARKED FIELDS
 - 7) REFERENCE GRA VIN 610300-ERA
 - 8) INSTALL RM41011 PLACARD PRIOR TO GLUING THE RBT18205-3 BOTTOM FOAM AND THE RBT18205-4 TOP FOAM TO THE PELICAN CASE

UNDER REVIEW
URP 17-661 SC

DART Hydraulic Filter Bowl Wrench			
RBT18205			
REV. 001	1/11/2017	REV. 001	1/11/2017
REV. 002	1/11/2017	REV. 002	1/11/2017
REV. 003	1/11/2017	REV. 003	1/11/2017
REV. 004	1/11/2017	REV. 004	1/11/2017
REV. 005	1/11/2017	REV. 005	1/11/2017
REV. 006	1/11/2017	REV. 006	1/11/2017
REV. 007	1/11/2017	REV. 007	1/11/2017
REV. 008	1/11/2017	REV. 008	1/11/2017
REV. 009	1/11/2017	REV. 009	1/11/2017
REV. 010	1/11/2017	REV. 010	1/11/2017

for
No. 18205

DQA:

Date:

1E Oct 3/19.



WORK ORDER NON-CONFORMANCE / UPDATE

QA Closed:

Date:

NCR-19-7385

Work Order update only ☐

Work Order: <u>168015</u> Part No. <u>RBT18205</u> NCR No.		DISPOSITION Rework ☒ Scrap ☐ Use-as-is ☐ Suspected Unapproved ☐		AGAINST DEPARTMENT/PROCESS Skid-tube ☐ Cross tube ☐ Water Jet ☐ Engineering ☒ <i>NCR</i> Machining ☐ Small Fab ☐ Prod. Eng. Coord. ☐ Quality ☐ Thermoforming ☐ Finishing ☐ Rec/Store/Packaging ☐ Other ☐ Large Fab ☐ Composite ☐ Supplier ☐					
Date: <u>17/11/9</u>		Step #: <u>100</u>		QTY Effective: <u>1</u>			MRB (QSI042) Approval DAS 12 9-89 17/11/9		
Description Work Order Deviation				Disposition				Completed By MCC 17/11/9	
INSTALL PLACARD WITH RIVETS PER MARKED-UP DLG (Attached). Job No: 168015 Mfg Date: 12/21/17				Acceptable Non-airworthy tooling.				Lead hand / Supervisor Approval Verification DAS 30 9-89 JUL 26 2019	
								QC / QA Coordinator Approval DAS 68 9-89 JUL 26 2019	

Start up Operation

PART NO: RBT18205

Hydraulic Filter Bowl Wrench



S026167

AEROSPACE



CATEGORY

☐	Power Loss/Surge	☐	Positioned Wrong
☐	Folio/Program	☐	Outside Dimensions
☐	Grain	☐	Over/Under tolerance
☐	Weld	☐	Part Incorrect
☐	Wrong Stock Pulled	☐	Part Lost/Missing
☐	Out of Sequence	☐	Part Moved
☐	Off-set	☒	Drawing
☐	Mislabeled	☐	Finish
☐	Fit/Function	☐	Misread
☐	Misaligned/off center	☐	Turning Sequence

H:/FOR

Dart Aerospace Ltd.

1270 Aberdeen Street
 Hawkesbury, ON K6A 1K7
 CANADA
 TEL.: 1 613 632-5200
 Email: sales@dartaero.com
 www.dartaerospace.com